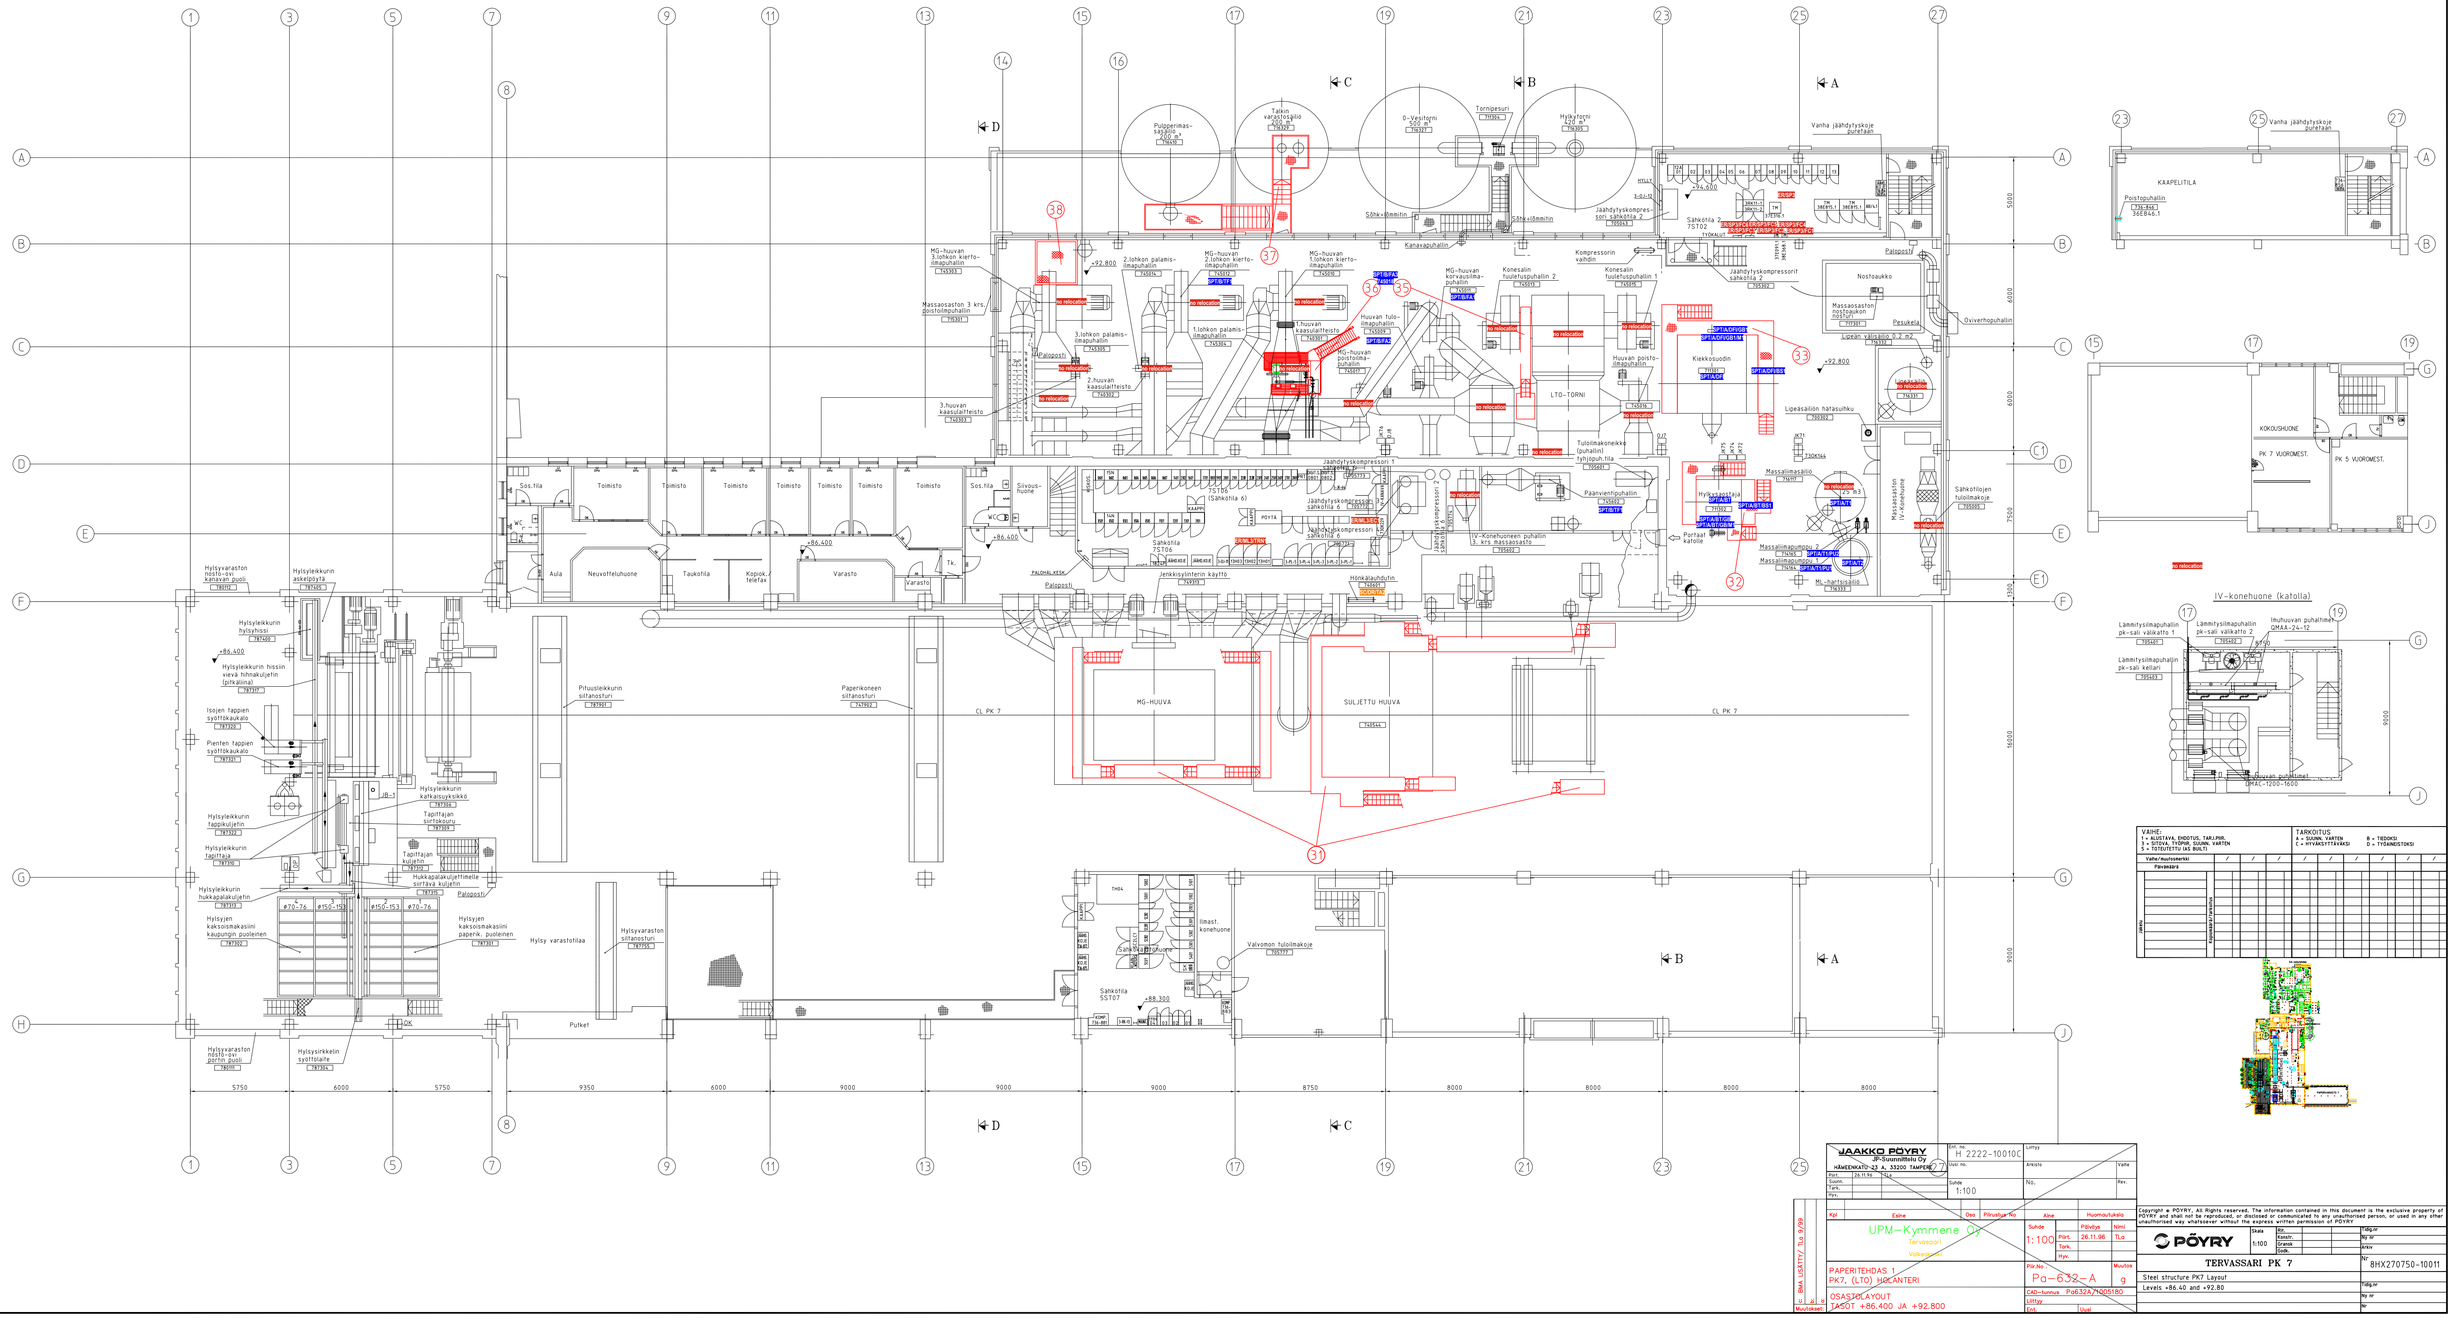

Merkki	Kpl	Pvm.	Tekijä	Hyv.	Muutos

VAIHE:
1 = ALUSTAVA, EHDOTUS, TARJ.PUR.
3 = SITOVA, TYÖPIIR, SUUNN. VARTEN
5 = TOTEUTETTU (AS BUILT)

TARKOITUS
A = SUUNN. VARTEN
C = HYVÄKSYTTÄVÄKSI
B = TIEDOKSI
D = TYÖANNETTAVAKSI

Vaihe/Huolhoterkki	/	/	/	/	/	/	/	/	/
Piirustaja									
Piirustaja									
Tarkastaja									
Tarkastaja									
Hyväksyjä									

JAAKKO PÖYRY
JP-Suunnittelu Oy
HÄMEENKATU 23 A, 33200 TAMPERE

	Pvm.	Tek.
Piirt.	26.11.96	TLa
Suunn.		
Tark.		
Hyv.		

Ent. no. H 2222-10010C
Liittyy
Arkisto
Vaihe
Nro.
Rev.
Suhde 1:100

Kpl	Esine	Osa	Piirustus-no	Aine	Huomautuksia
	UPM-Kymmene Oy			Suhde 1:100	Piirtäjä Nimi
	Tervasaari			Piirt. 26.11.96	TLa
	Valkeasaari			Tark.	
	PAPERITEHDAS 1			Hyv.	
	PK7, (LTO) HUOLTANTERI			Piir.No Pa-632-A	Muutos g
	OSASIJOITUSLAYOUT			CAD-tunnus Pa632A7405180	
	TASOT +86.400 JA +92.800			Liittyy	
				Ent.	Uusi

Muutokset

Copyright © PÖYRY. All Rights reserved. The information contained in this document is the exclusive property of PÖYRY and shall not be reproduced, or disclosed or communicated to any unauthorised person, or used in any other unauthorised way whatsoever without the express written permission of PÖYRY.

PÖYRY
Skala 1:100
Kirj.
Kenstr.
Grandk
Tark.
Hyv.
Tilaaj.nr
Ng' nr
Arkiv
Nr

TERVASSARI PK 7
Nr 8HX270750-10011

Steel structure PK7 Layout
Levels +86.40 and +92.80

Tilaaj.nr
Ng' nr
Nr

MARGIZ SP. Z O.O.
Industrie Demontage & Montage

Match marking areas for Pm7 top level 86.40
For blowers room only elements indicated in 17.11.2016 meeting are to transfer